




BRIDGE TOP DECK
 BRIDGE DECK
 04 DECK
 03 DECK
 02 DECK
 MAIN DECK
 1ST DECK

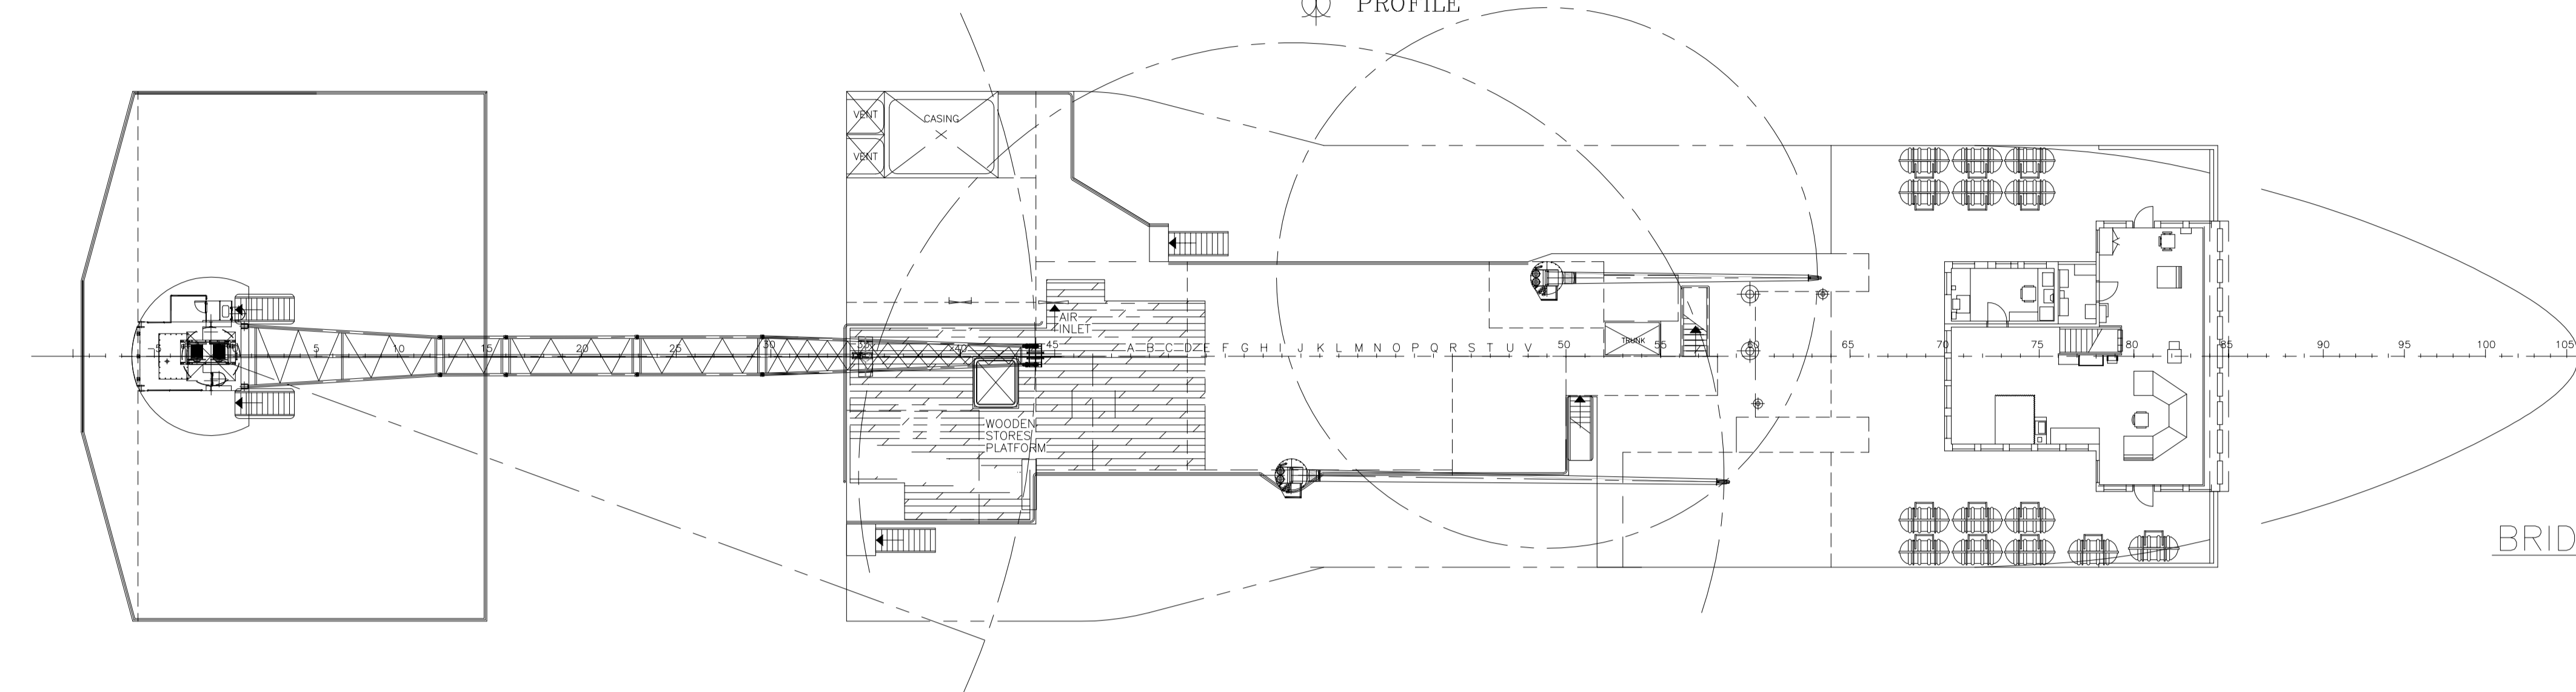


BRIDGE DECK

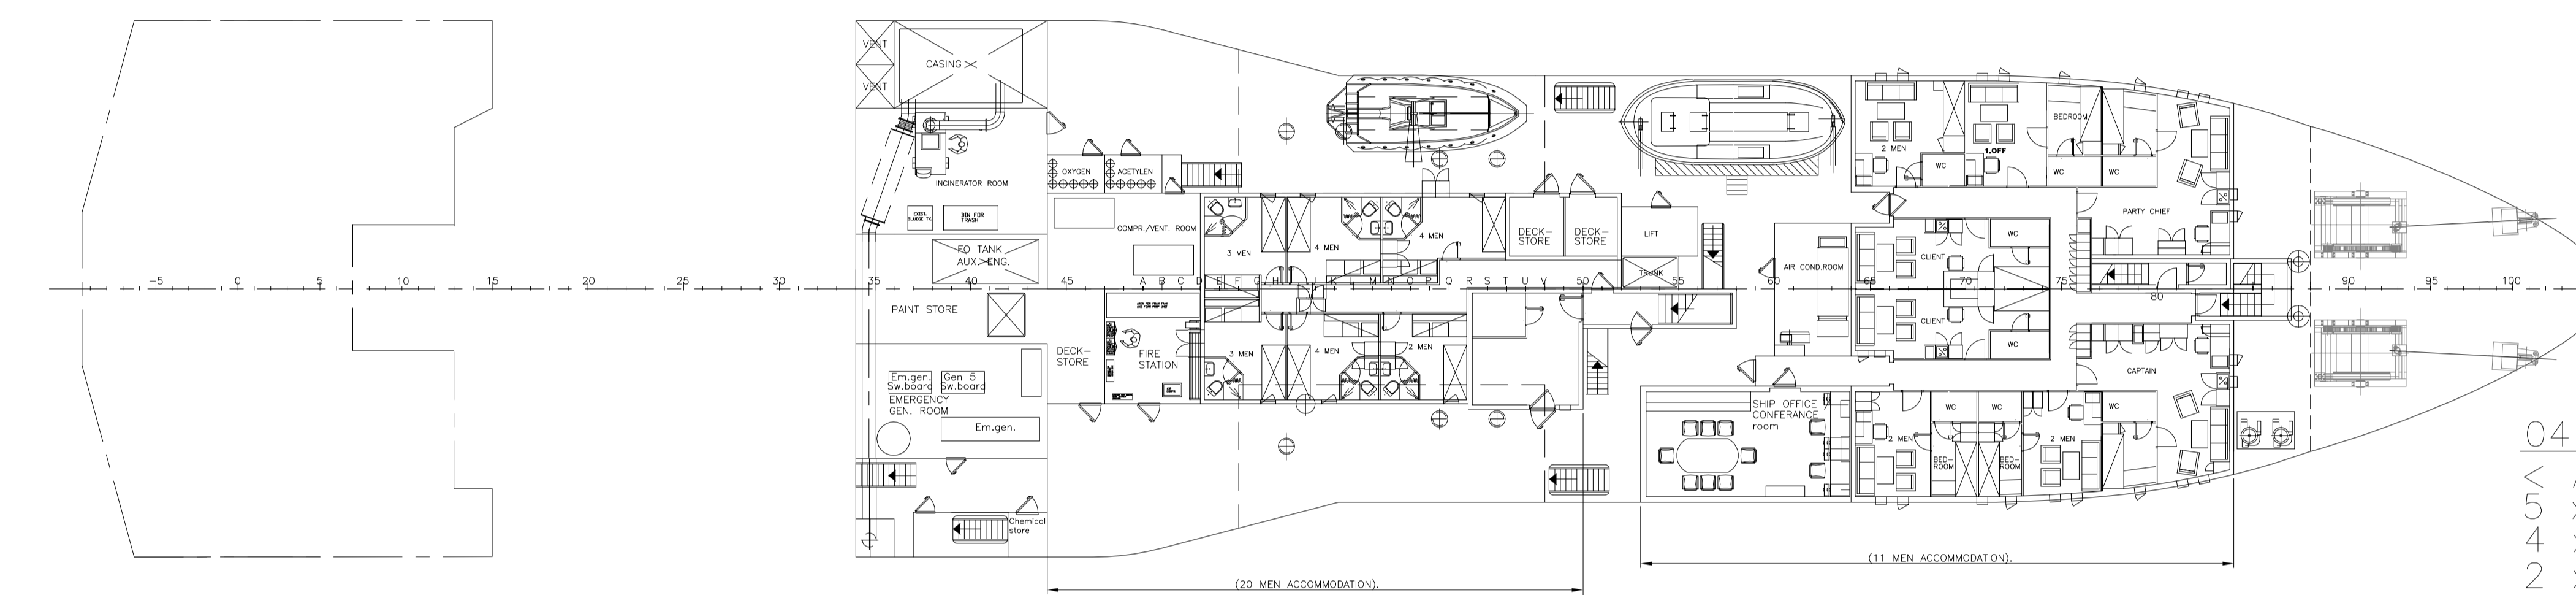


04 DECK
 < A > (31 MEN)
 5 x 1P
 4 x 2P
 2 x 3P
 3 x 4P

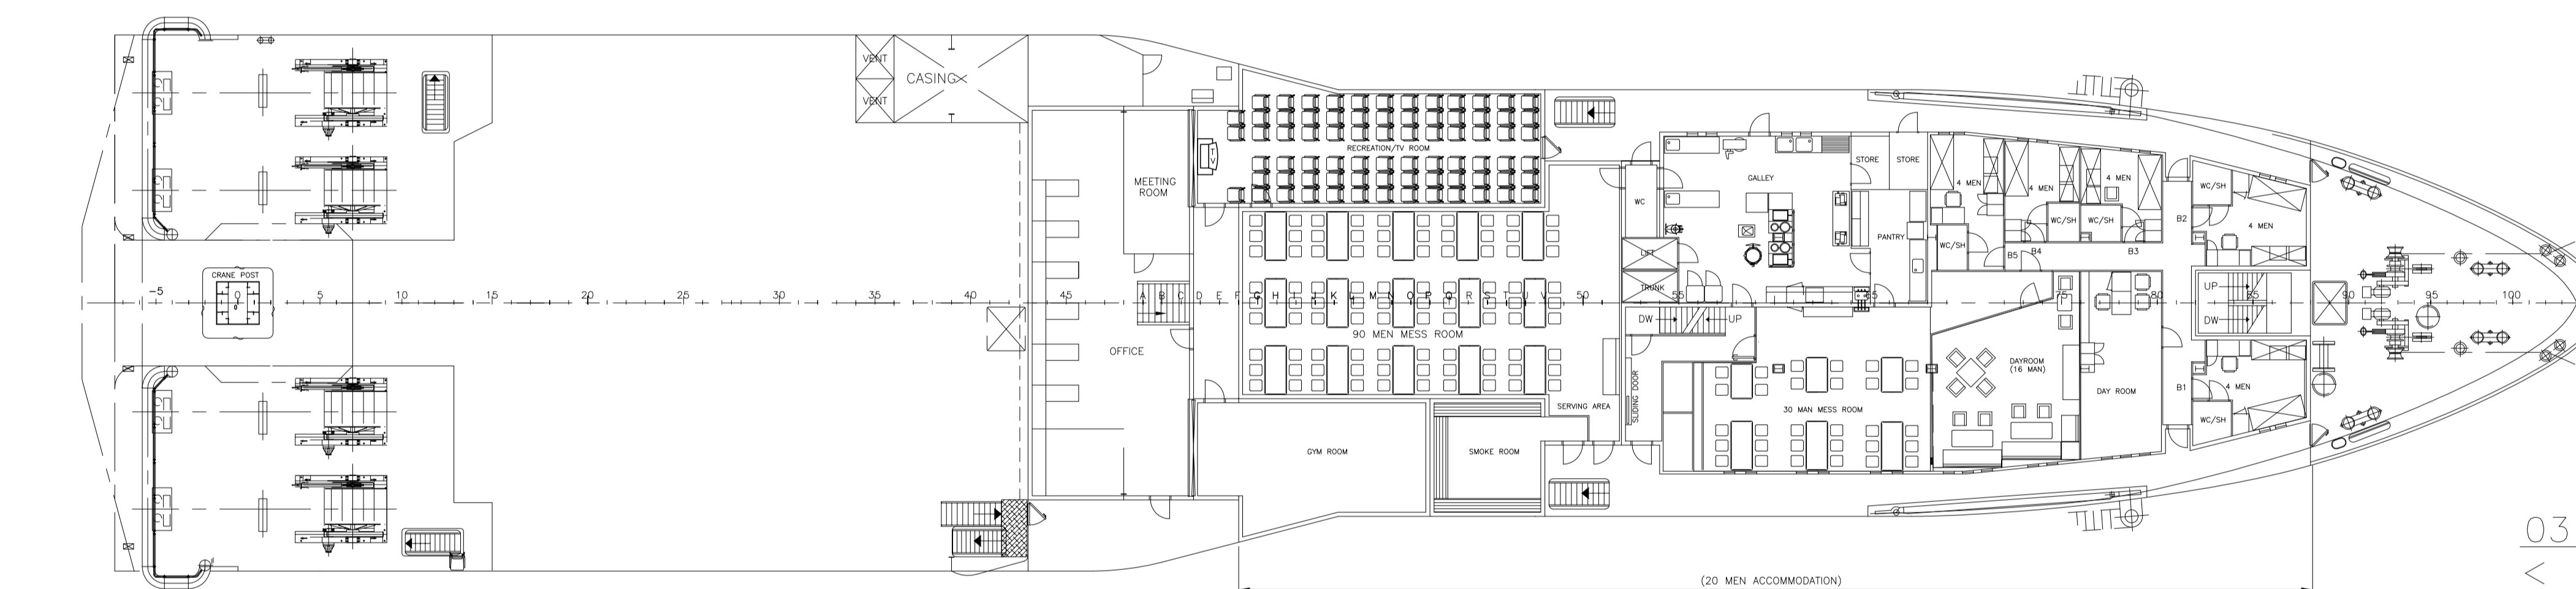


03 DECK
 < B > (20 MEN)
 5 x 4P

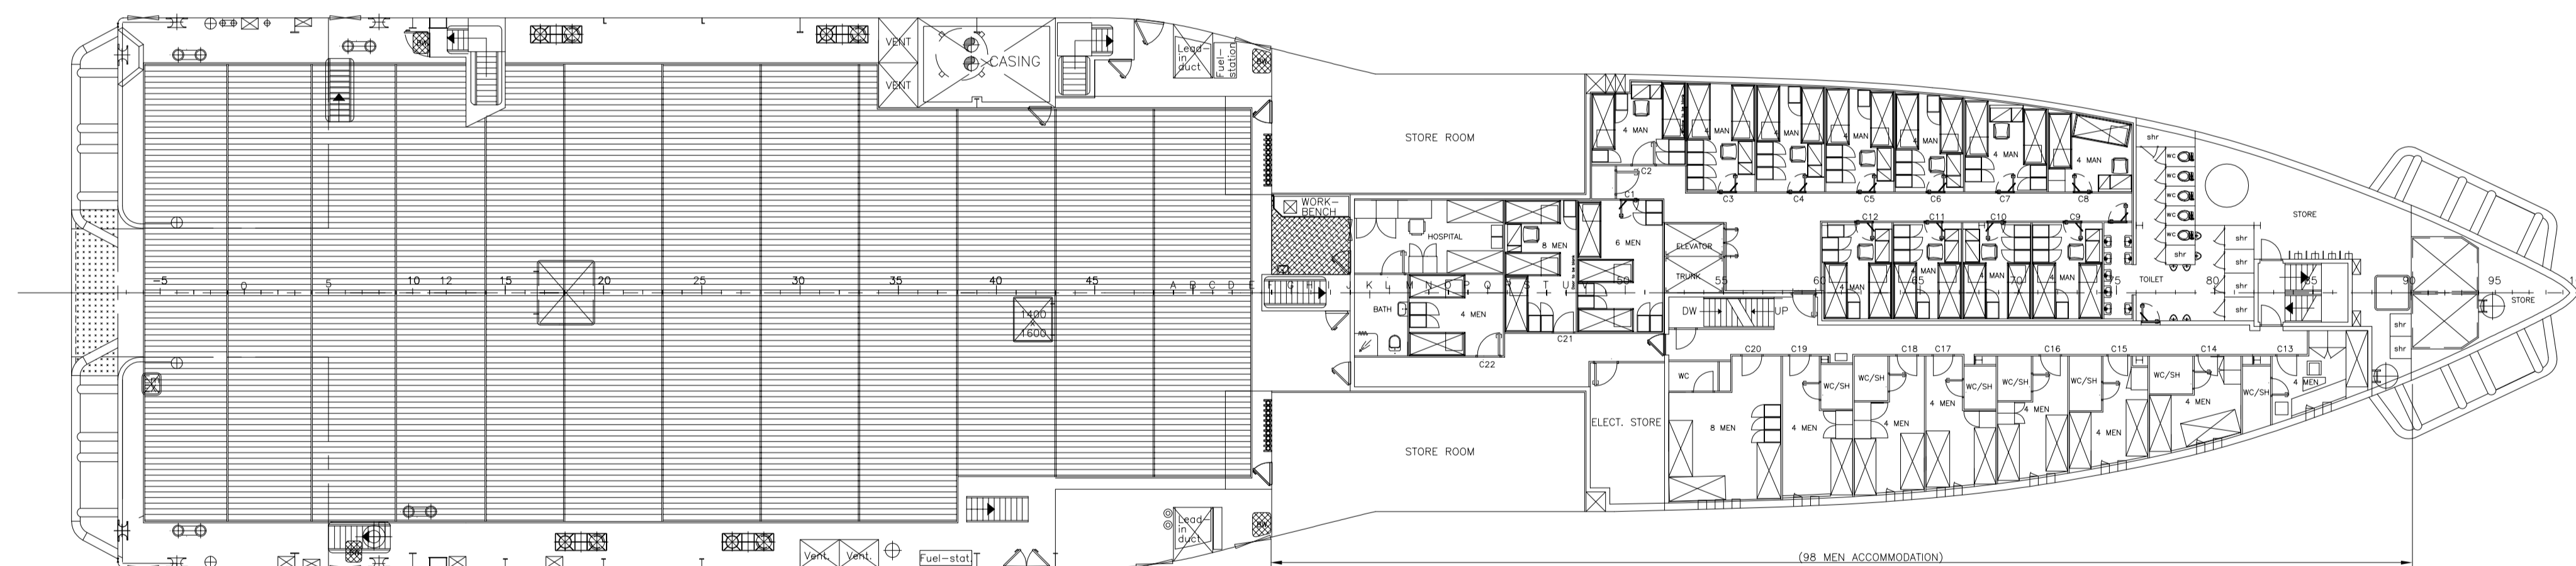

02 DECK
 < C > (98 MEN)
 19 x 4P
 1 x 6P
 2 x 8P

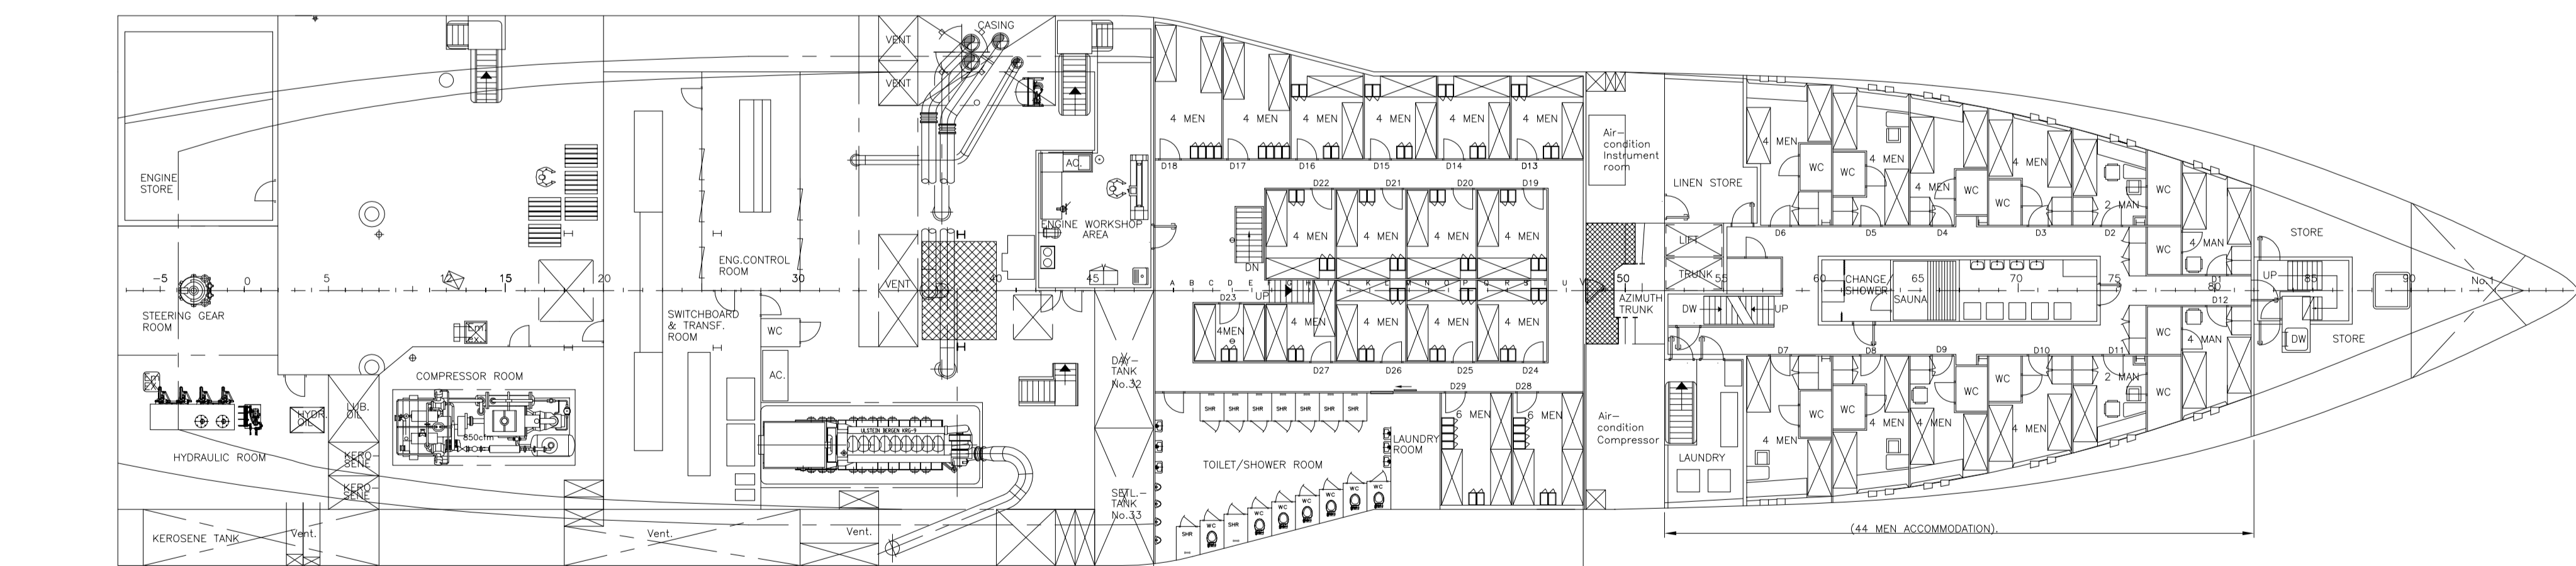

MAIN DECK
 < D > (116 MEN)
 2 x 2P
 25 x 4P
 2 x 6P

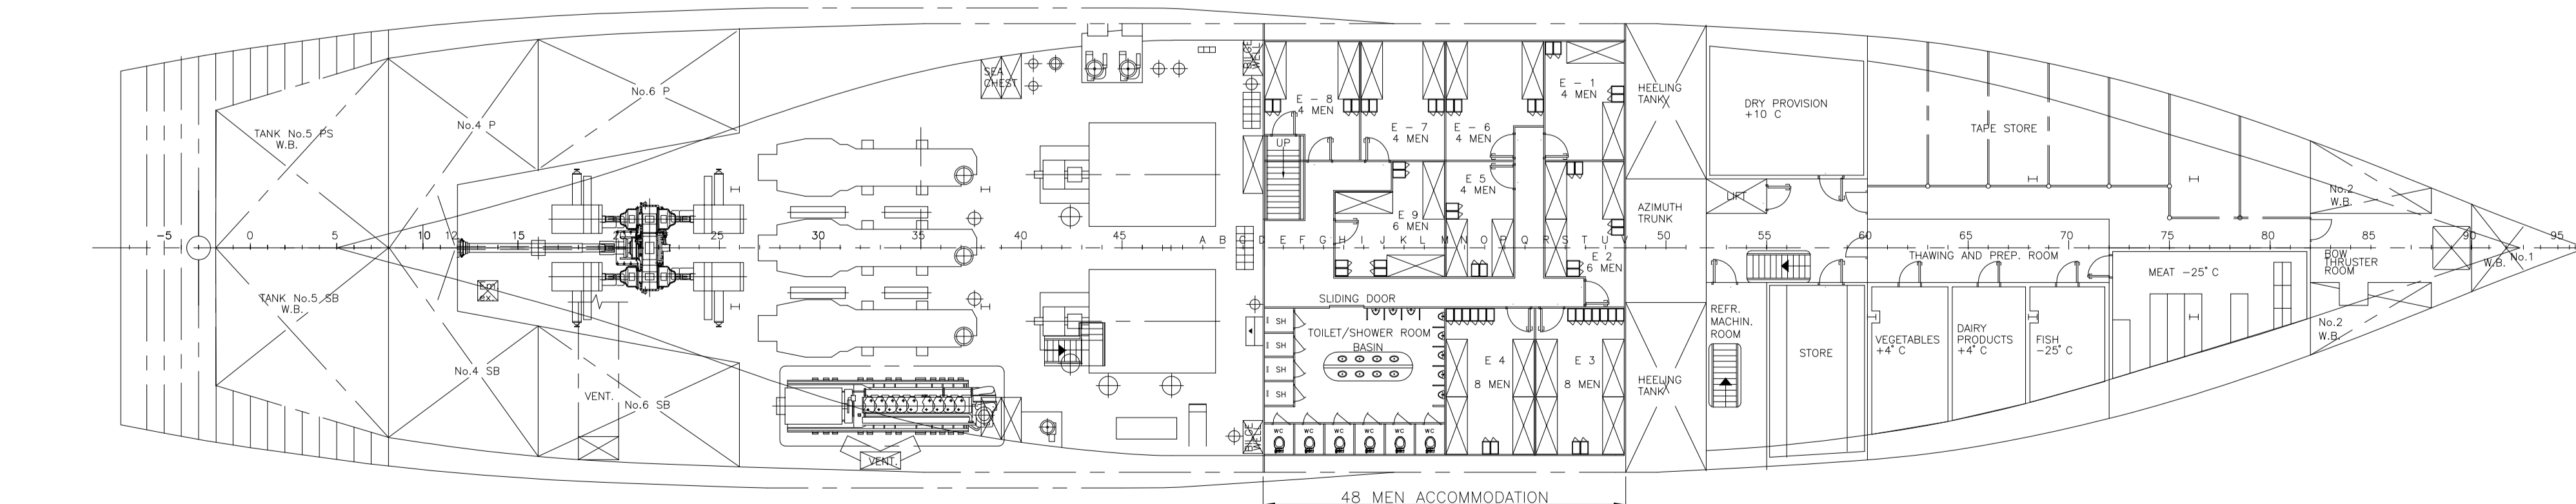

1ST DECK
 < E > (48 MEN)
 5 x 4P
 2 x 6P
 2 x 8P

PRINCIPLE PARTICULAR

LENGTH OVERALL: 92.30m
 BREADTH MOULDED: 15.60m/19.60m
 DEPTH MOULDED: 8.50m
 MAX DRAFT: 6.40m
 COMPLEMENT: 310

THIS DOCUMENT AND THE INFORMATION IT CONTAINS IS COPYRIGHT AND REMAINS THE PROPERTY OF TRINITY OFFSHORE PTE LTD. IT IS NOT TO BE COPIED IN WHOLE OR IN PART OR DISCLOSED TO ANY THIRD PARTY FOR ANY PURPOSE WHATSOEVER WITHOUT PRIOR WRITTEN CONSENT.

Rev.	Date	Description
0	13/11/14	Updated As built
Drawn by: KYT		Check by: SNG
		Approve by: SNG

Date: 27.12.04 Scale: 1:500 A3
 Project: TRINITY BETA
 Title: **GENERAL ARRANGEMENT PLAN**

TRINITY OFFSHORE PTE LTD
 NO.4 LOYANG CRESCENT, SINGAPORE 508979
 TEL. NO. 65431000 FAX. NO. 65451000
 EMAIL ADDRESS : admin@trinityoffshore.com