



**PRINCIPLE PARTICULAR**


**LENGTH OVERALL:** : 55.000 m  
**BREADTH MOULDED:** : 14.800 m  
**DEPTH MOULDED:** : 3.300 m  
**MAX DRAFT:** : 2.300 m  
**CLASSIFICATION:** : GL + 100A4 (PONTOON)  
**TONNAGE:** : LESS 1000 BRT  
**DEADWEIGHT:** : 700t  
**CRANE:** : 53t / 7m  
**COMPLEMENT:** : 134 PERSONS  
**GENERATOR:** : 2 X 440kW, 1 X 150 kW  
**MAIN DECK AREA:** : 402 m<sup>2</sup>

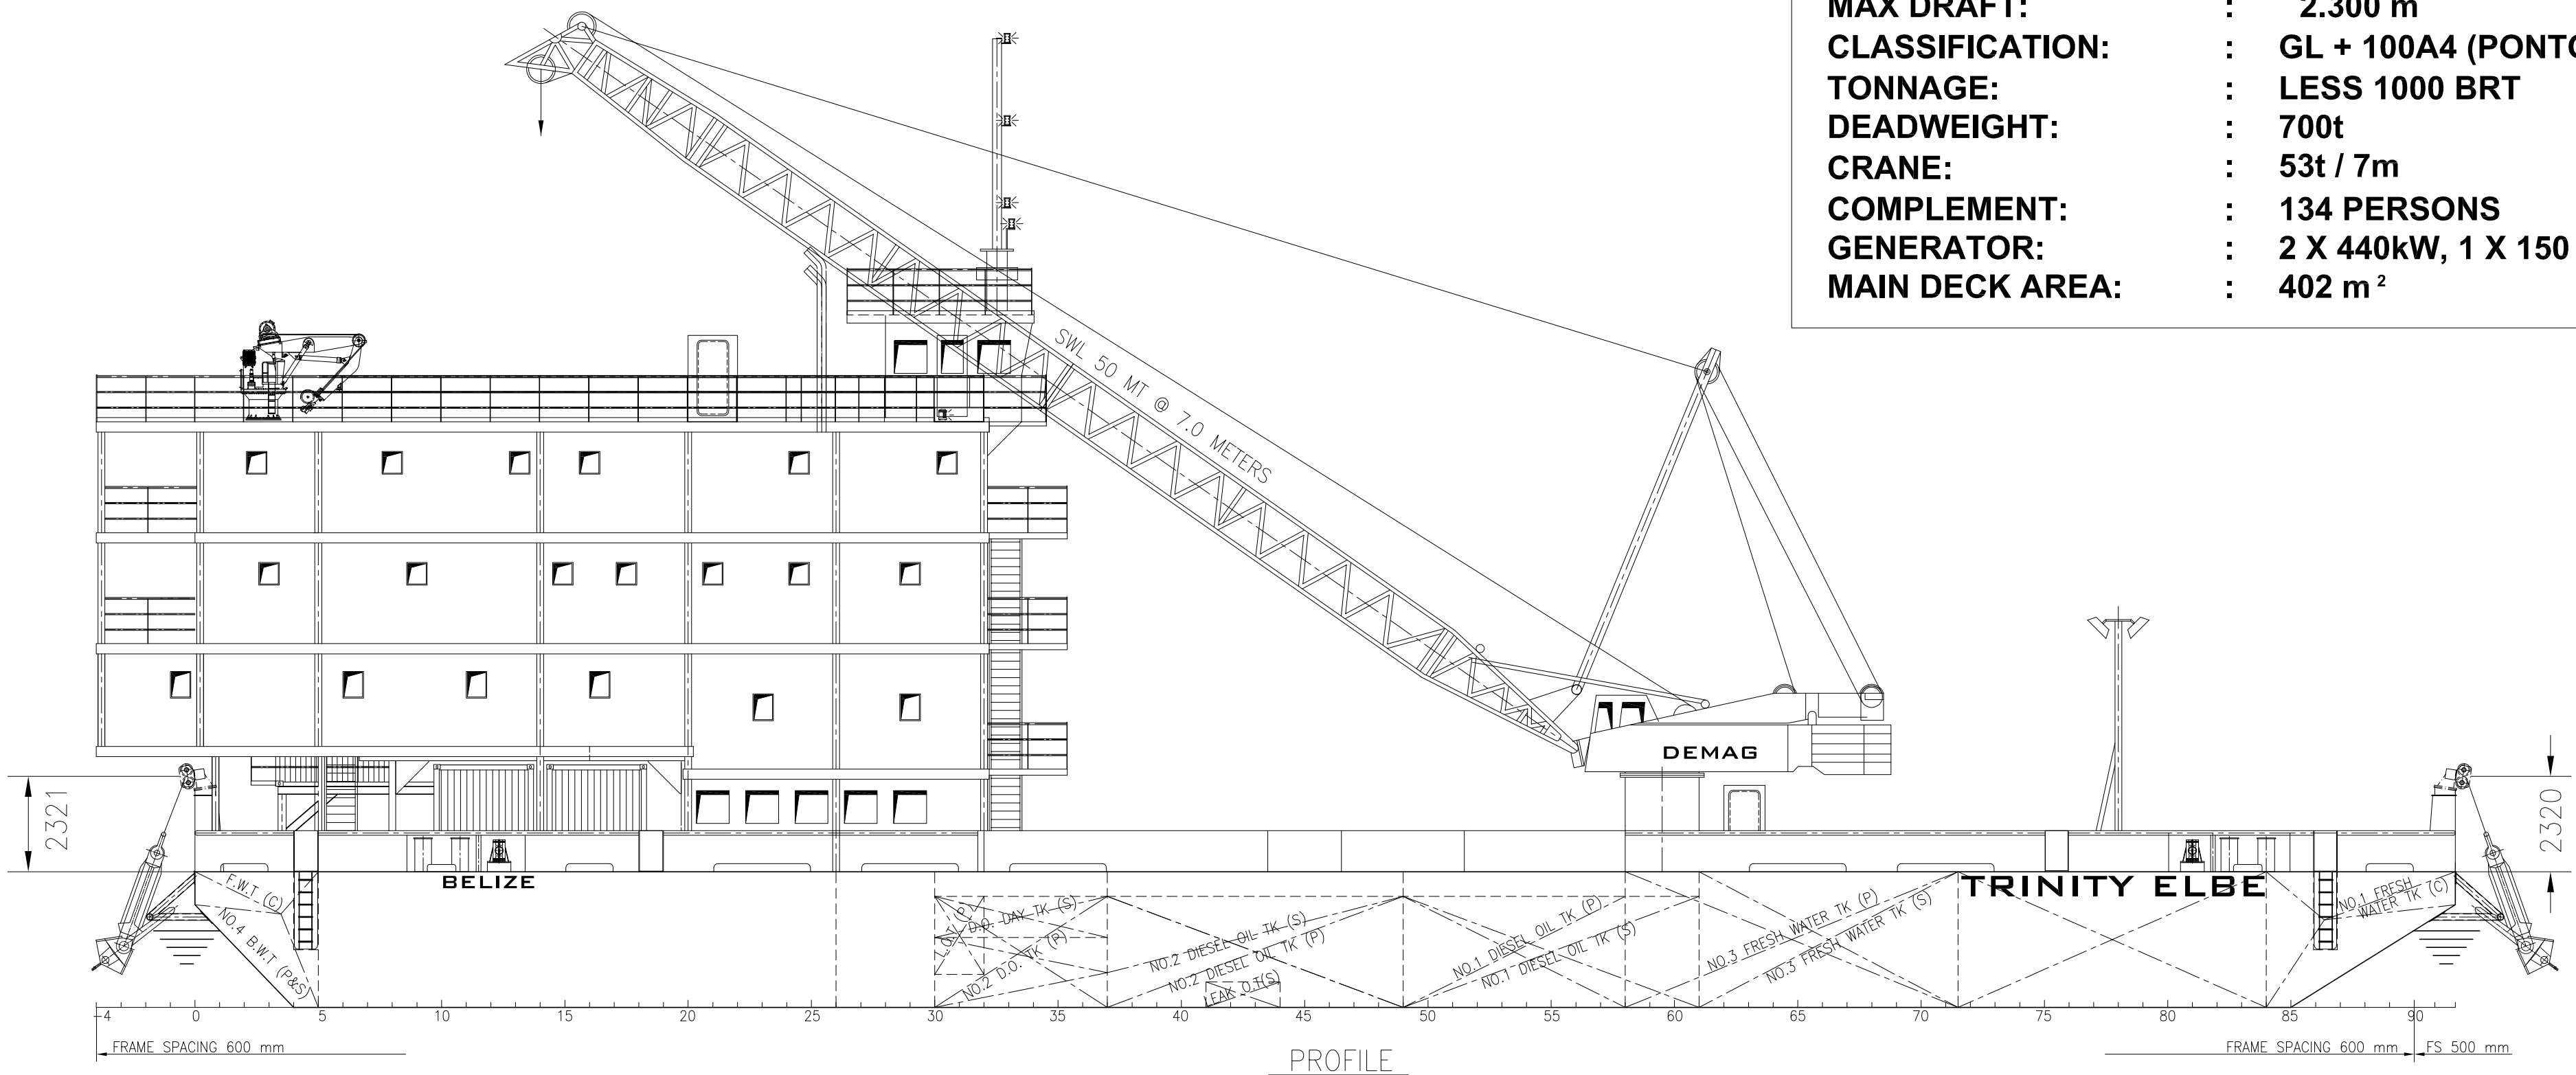

PROFILE

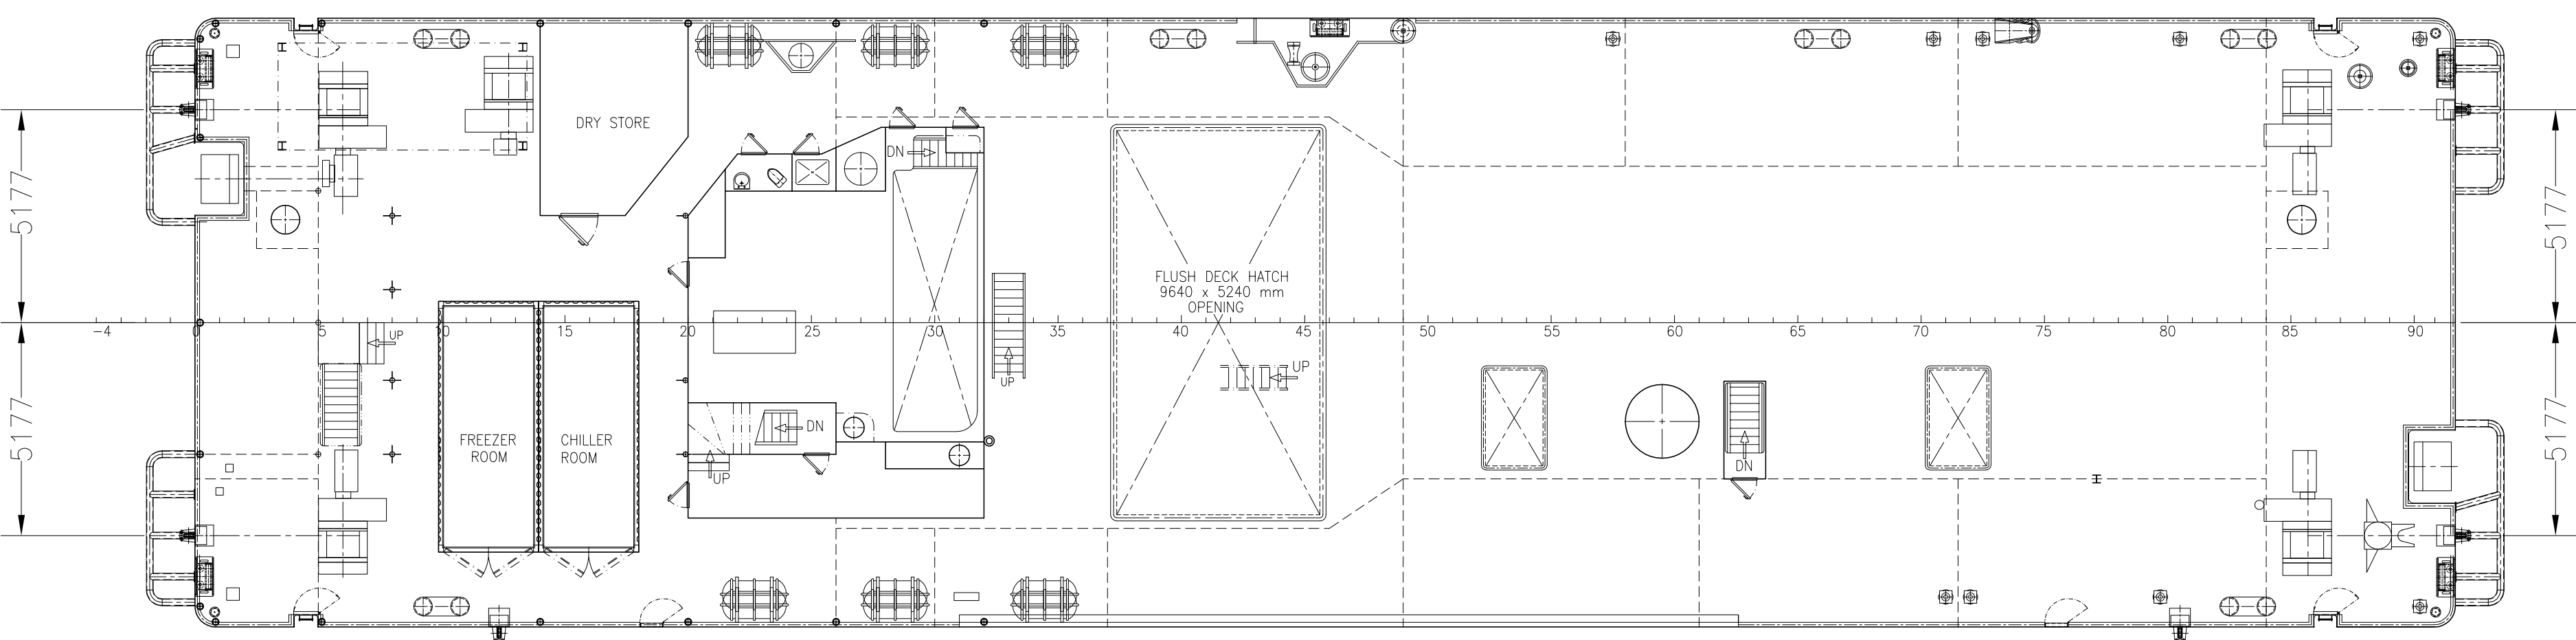

MAIN DECK

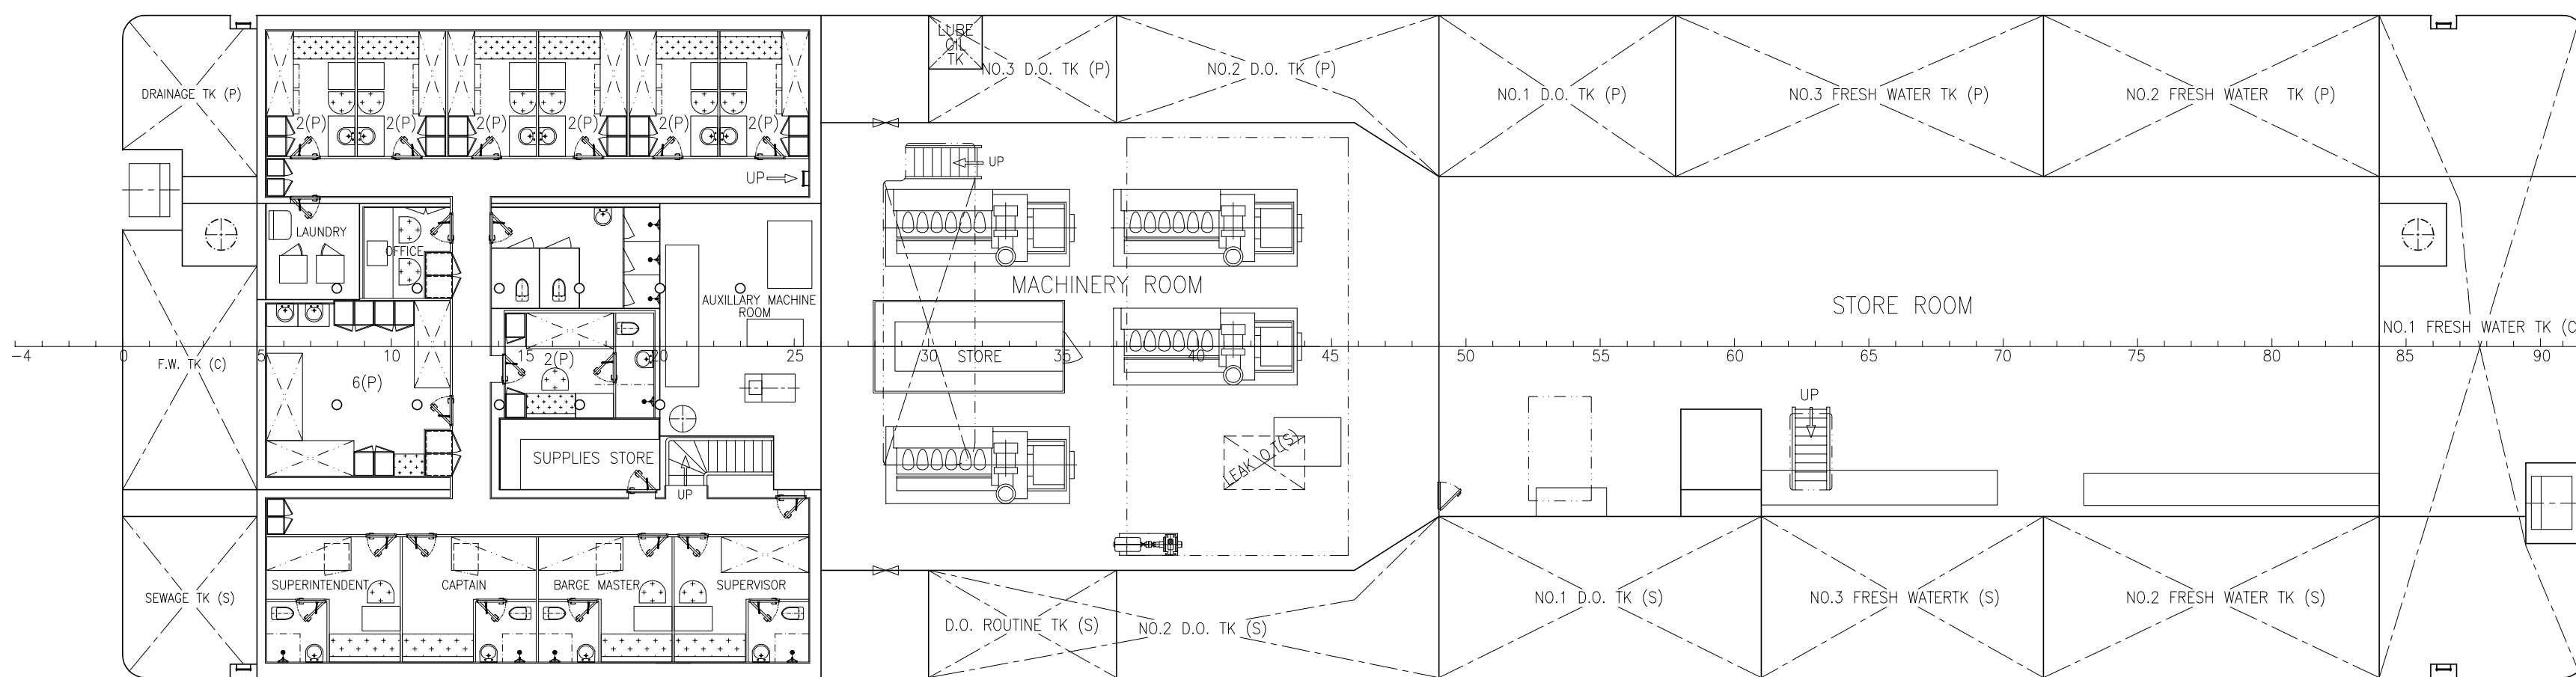

BELOW MAIN DECK  
(25 P)

THIS DOCUMENT AND THE INFORMATION IT CONTAINS IS COPYRIGHT AND REMAINS THE PROPERTY OF TRINITY OFFSHORE PTE LTD. IT IS NOT TO BE COPIED IN WHOLE OR IN PART OR DISCLOSED TO ANY WRITTEN CONSENT.

Rev.	Date	By	Description
1.	8/4/14	PPP	UPDATED ASBUILT
Drawn by: PPP		Check by: SNG	Approve by: SNG

**Date:** 08.04.14 **Scale:** 1:300 **A3**  
**Project:** TRINITY ELBE  
**Title:**  
**GENERAL ARRANGEMENT PLAN**

**TRINITY OFFSHORE PTE LTD**  
 NO.4 LOYANG CRESCENT, SINGAPORE 508979  
 TEL. NO. 65431000 FAX. NO. 65451000  
 EMAIL ADDRESS : admin@trinityoffshore.com