
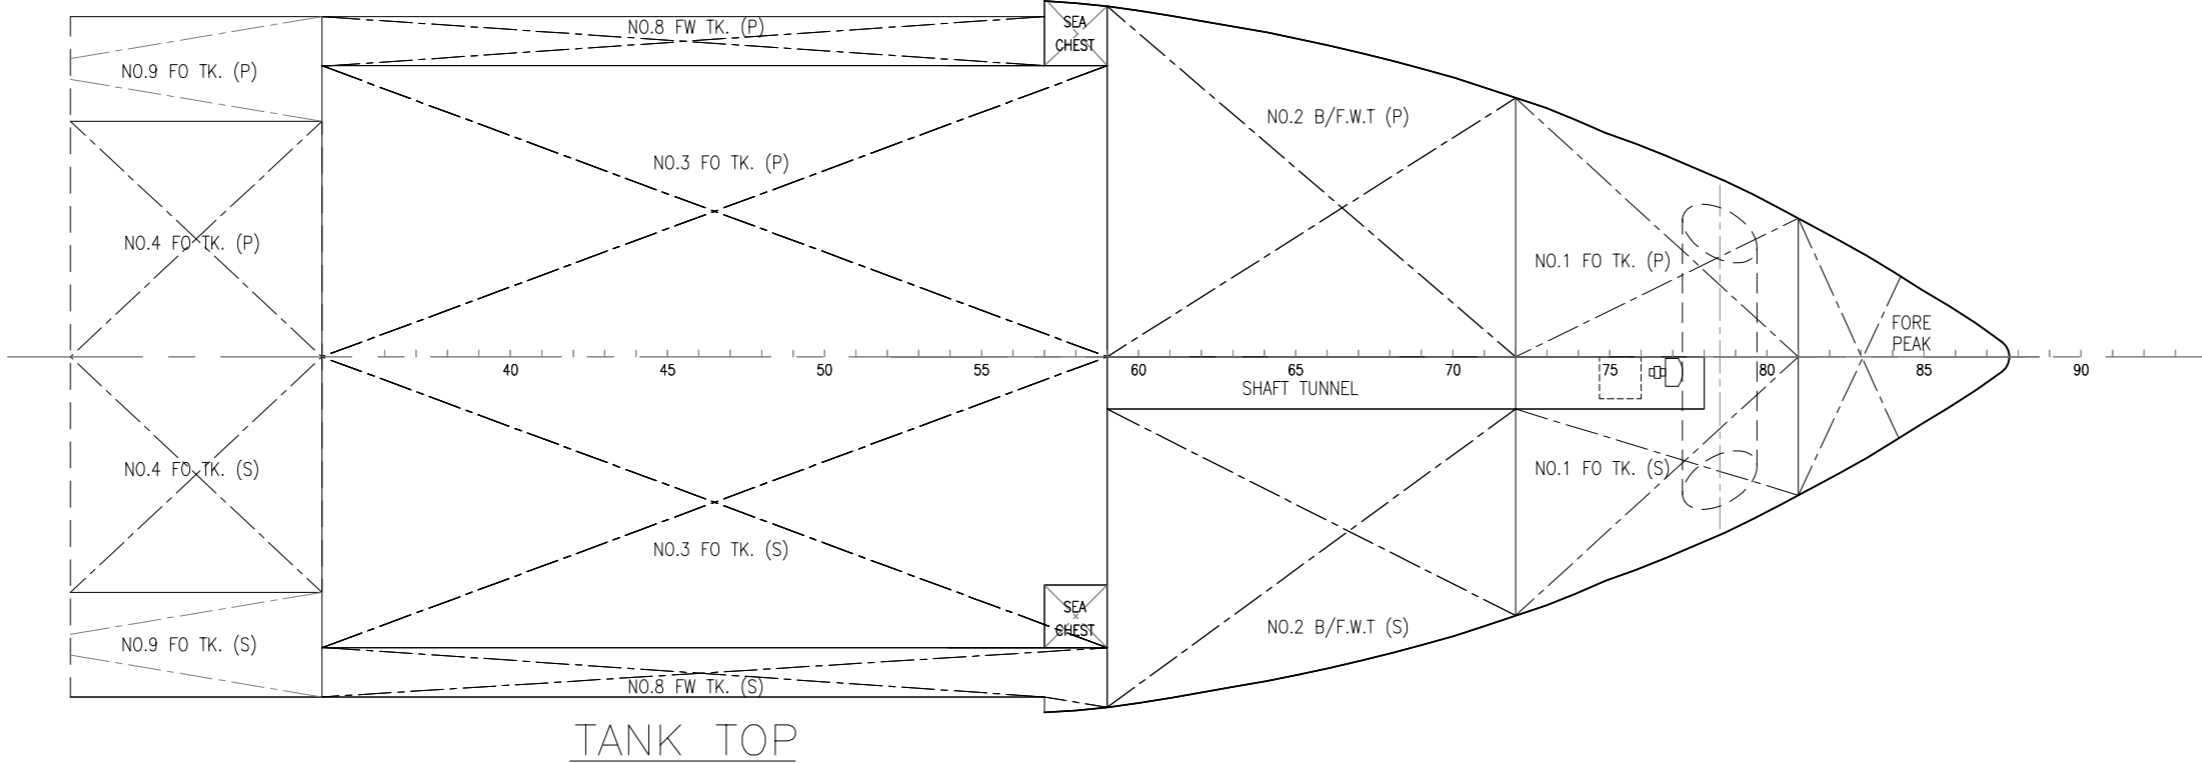
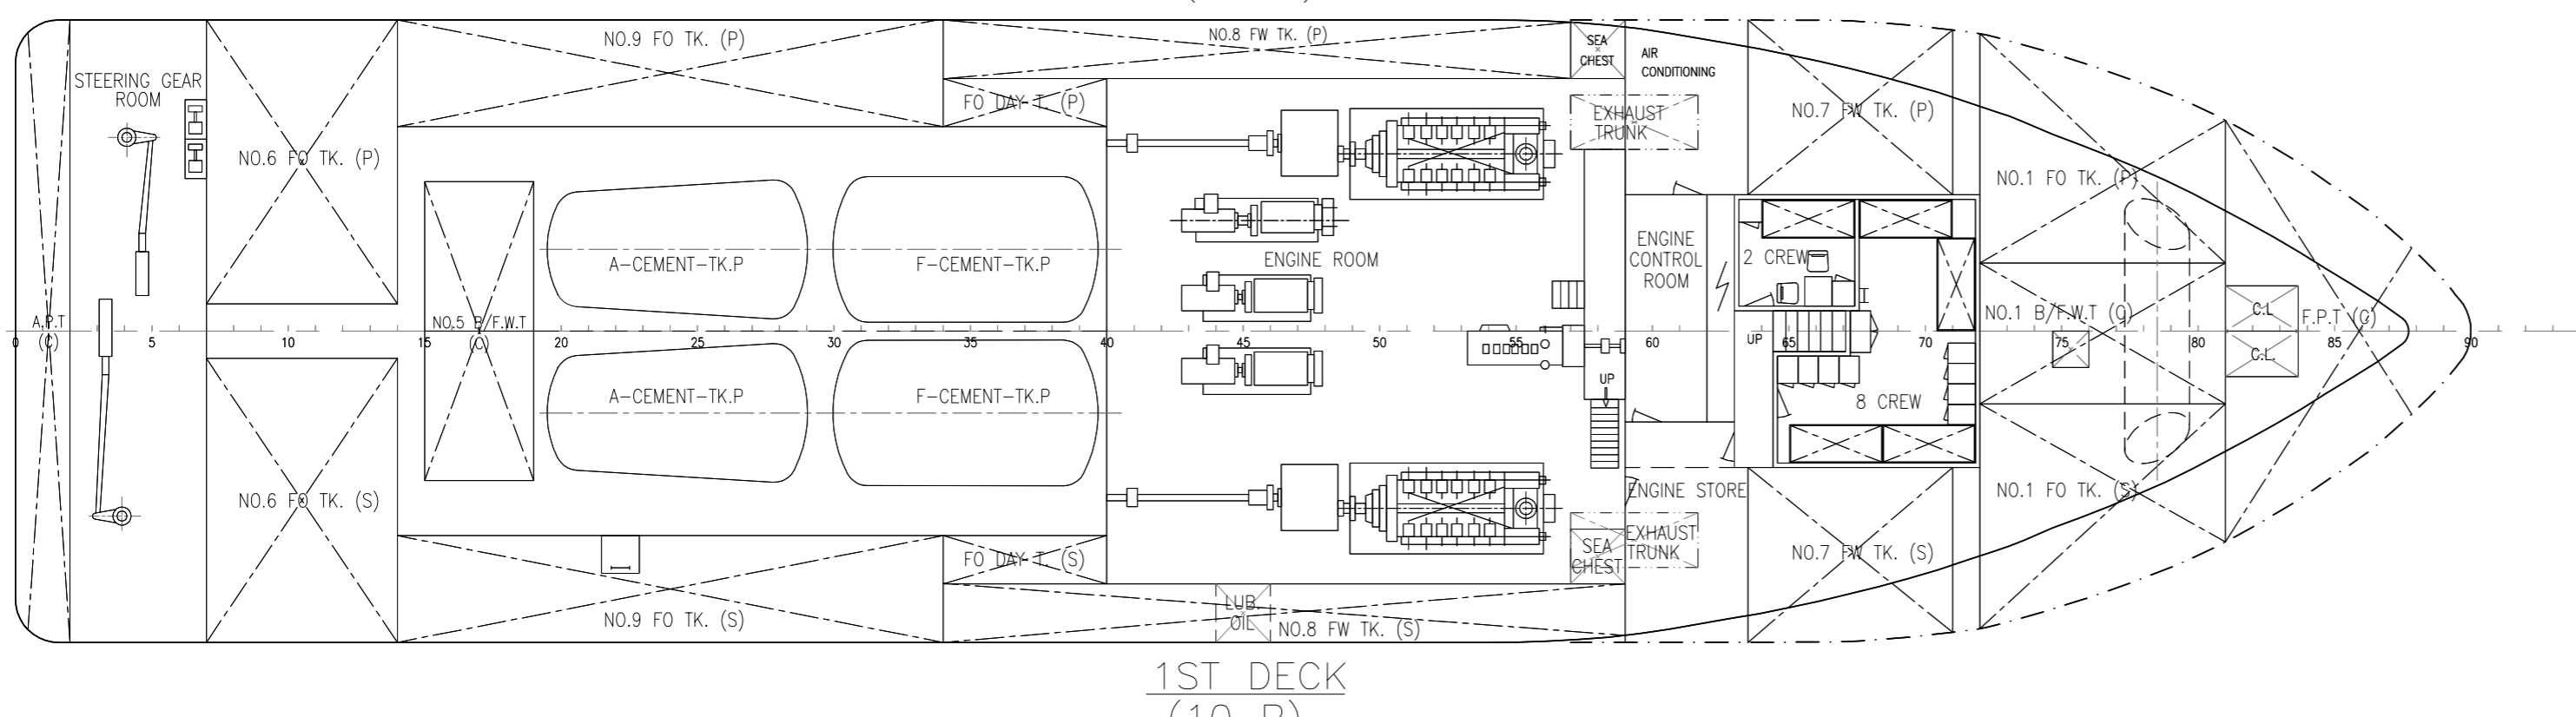
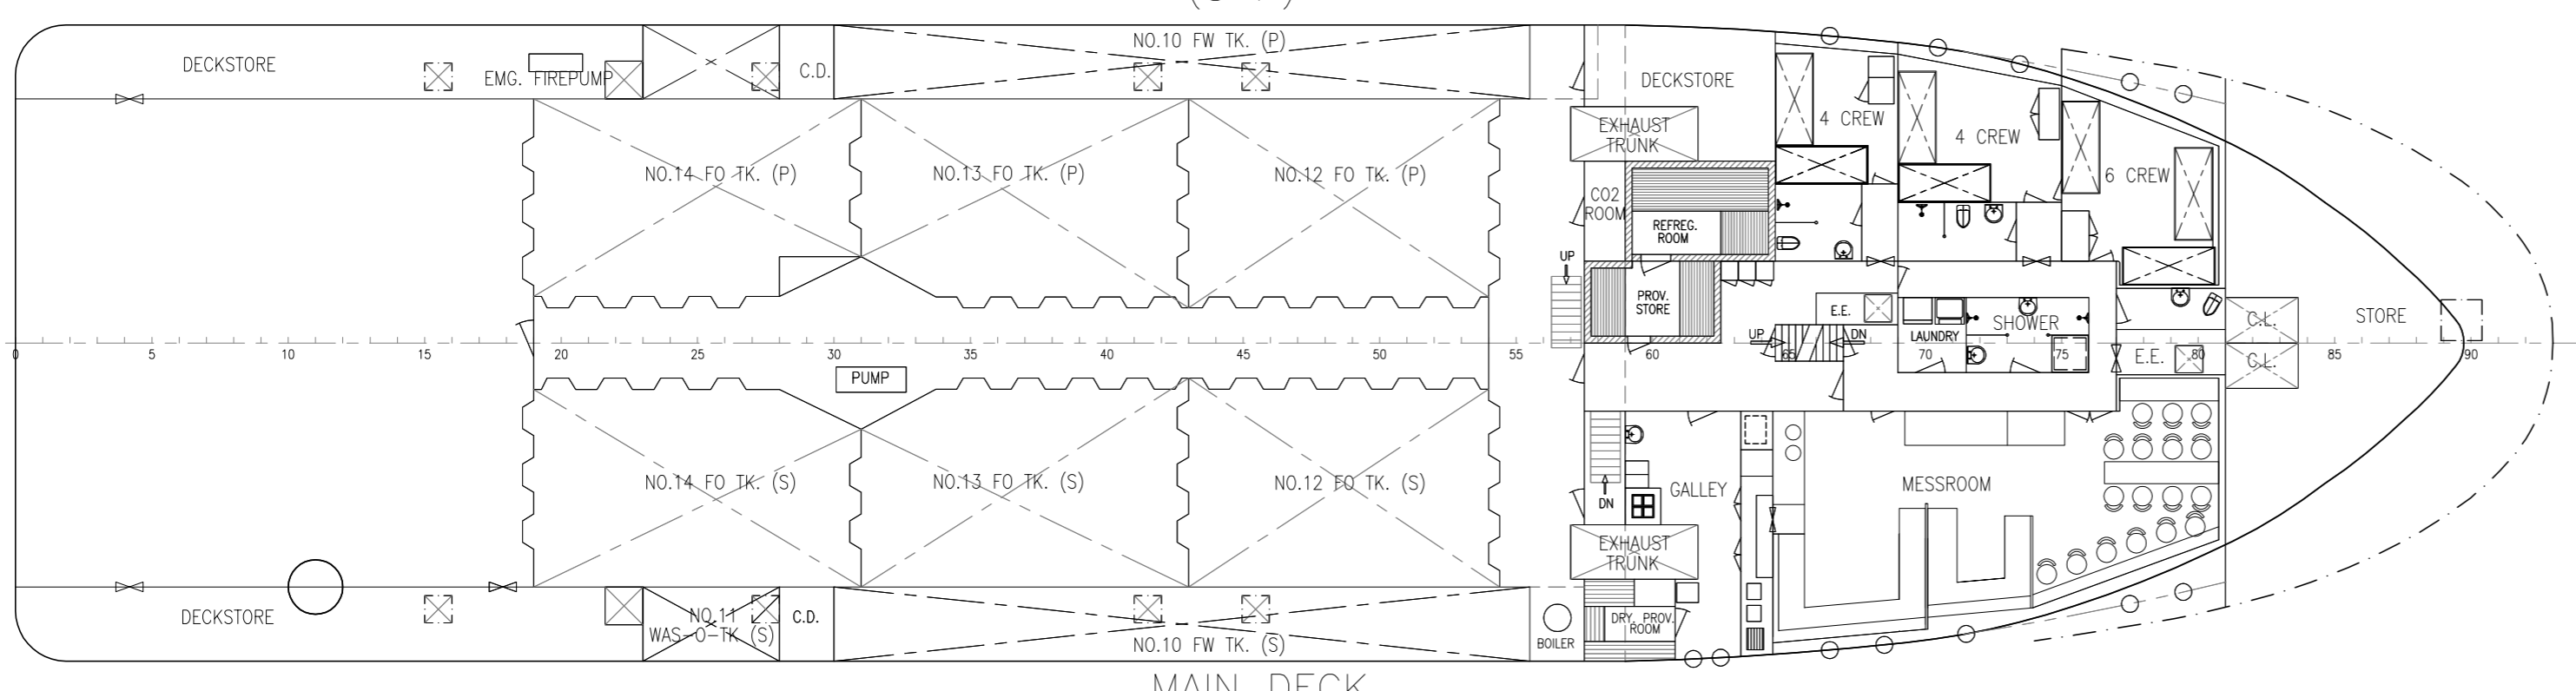
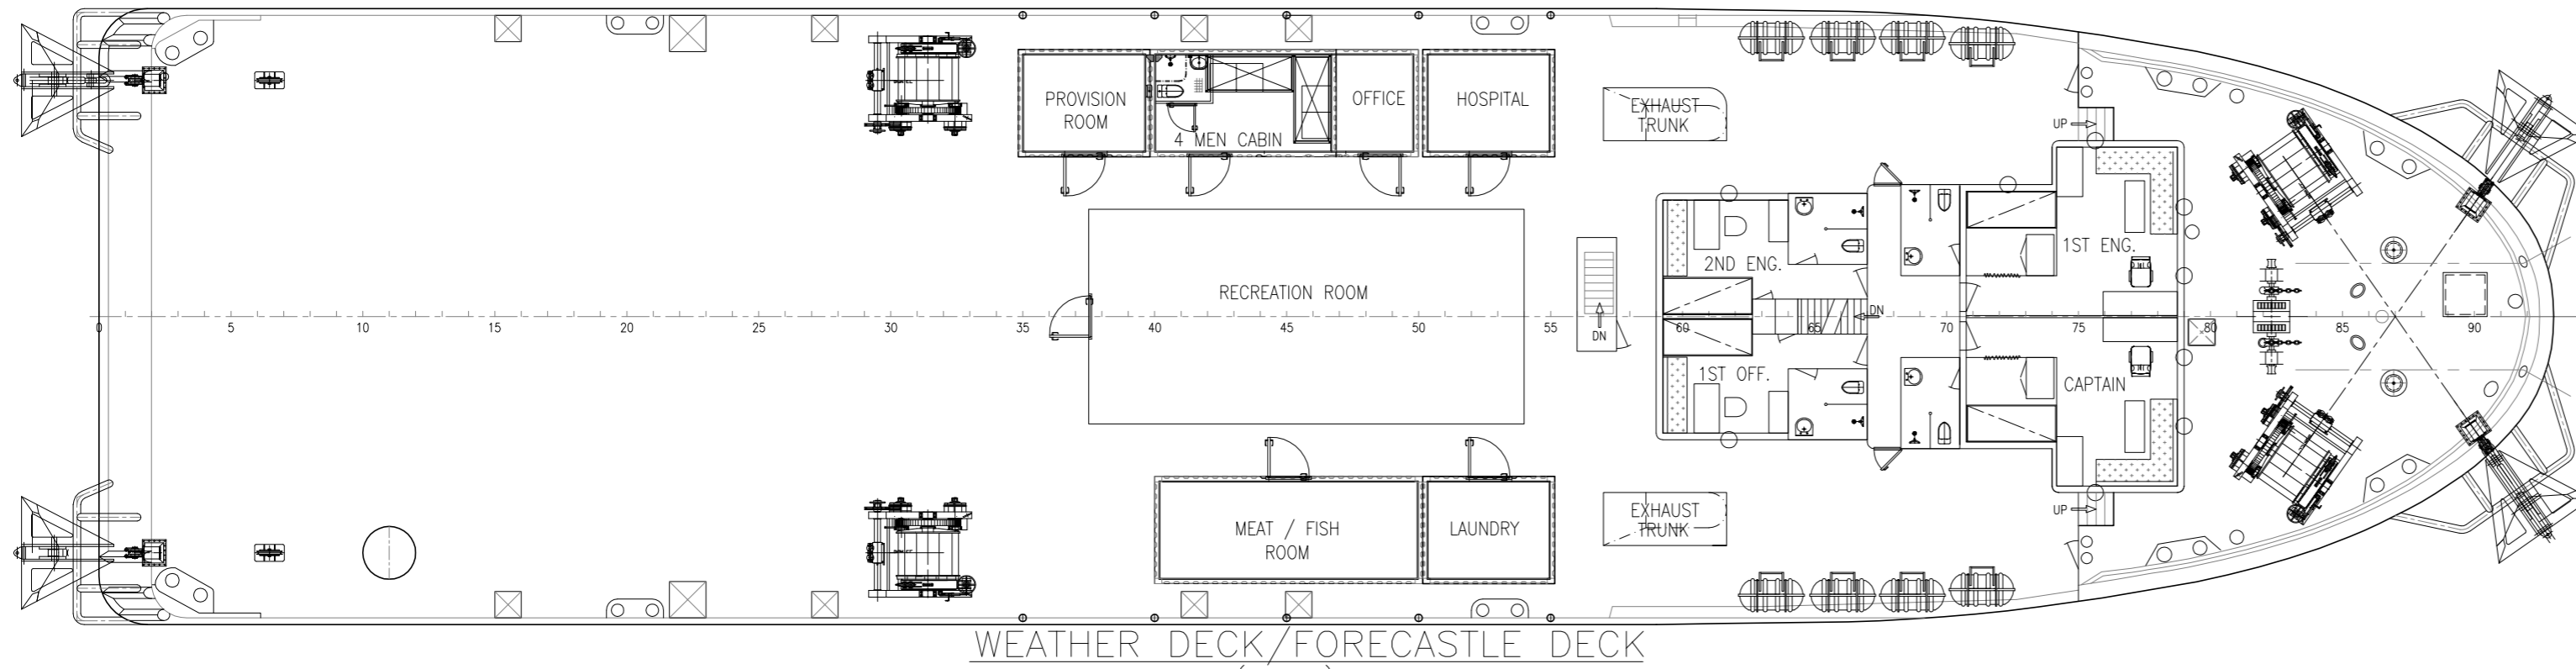


- WHEELHOUSE TOP
- WHEELHOUSE DECK
- BRIDGE DECK
- FORECASTLE DECK
- MAIN DECK
- 1ST DECK
- TANK TOP

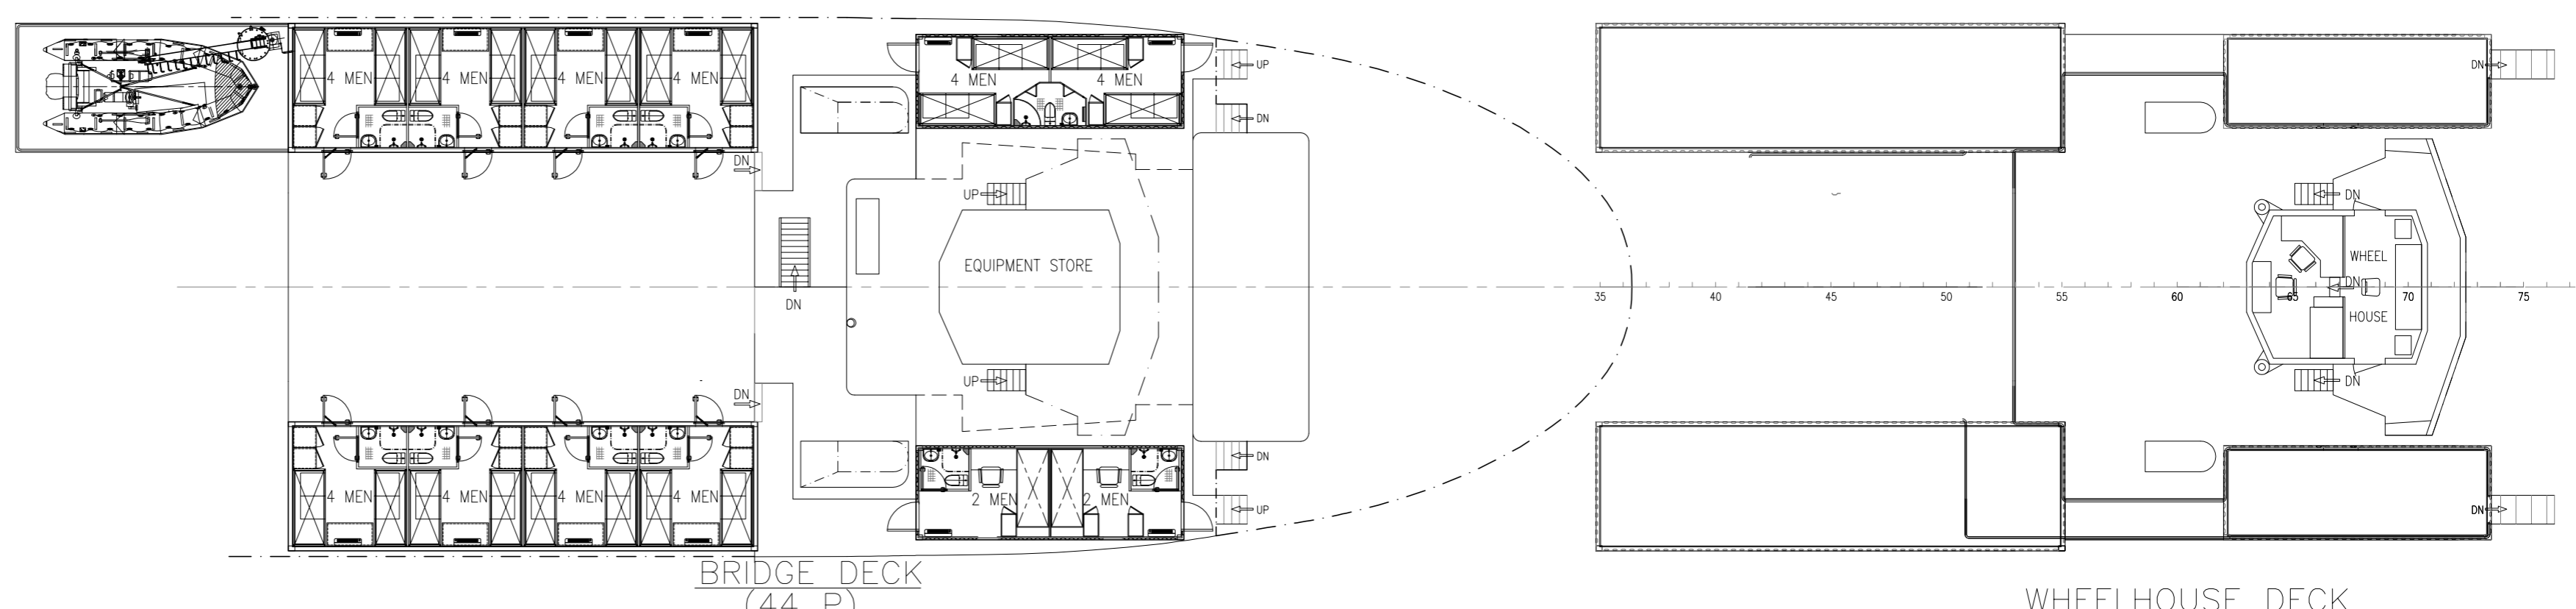

PRINCIPLE PARTICULAR

LENGTH OVERALL: 56.12m
 BREADTH MOULDED: 14.00m/19.60m
 DEPTH MOULDED: 7.58m
 MAX DRAFT: 5.154m
 COMPLEMENT: 76 PAX

THIS DOCUMENT AND THE INFORMATION IT CONTAINS IS COPYRIGHT AND REMAINS THE PROPERTY OF TRINITY OFFSHORE PTE LTD. IT IS NOT TO BE COPIED IN WHOLE OR IN PART OR DISCLOSED TO ANY THIRD PARTY FOR ANY PURPOSE WHATSOEVER WITHOUT PRIOR WRITTEN CONSENT.

Rev.	Date	Description
6	13/11/14	Updated as built
Drawn by: KYT		Check by: SNG
		Approve by: SNG

Date: 09.09.08 Scale: 1:300 A3
 Project: TRINITY LONDON
 Title: GENERAL ARRANGEMENT PLAN

TRINITY OFFSHORE PTE LTD
 NO.4 LOYANG CRESCENT, SINGAPORE 508979
 TEL. NO. 65431000 FAX. NO. 65451000
 EMAIL ADDRESS : admin@trinityoffshore.com